



GUAM POWER AUTHORITY

ATURIDÁT ILEKTRESEDÁT GUÅHAN
P.O.BOX 2977 • HAGÁTÑA, GUAM U.S.A. 96932-2977

July 15, 2024

AMENDMENT NO.: I

TO

INVITATION FOR BID NO.: GPA-102-24

FOR

FADIAN – EMPLOYEE PARKING GATE REPLACEMENT (DESIGN-BUILD)

Prospective Bidders are hereby notified of the following responses to inquiries received from Bidder No. 7 dated July 10, 2024:

QUESTION:

1. How far is the server from the existing card reader at the gate?

ANSWER:

Kindly refer to attached as built drawings.

QUESTION:

2. Is it possible to acquire Asbuilt drawing of the one-line diagram of the existing gate security system? This will be useful on the proposed design.

ANSWER:

Kindly refer to attached as built drawings.

QUESTION:

3. **Sliding Gate-** as discussed during the site walk through, existing gate will be removed and disposed of. Are we considering to refurbished and fix it as a backup security during weekends or at nights or during holidays for added protection for the facility? This can be operated manually or remotely if given an option.

ANSWER:

The Authority stands firm with the bid specifications set forth in this IFB.

All other Terms and Conditions in the bid package shall remain unchanged and in full force.


JOHN M. BENAVENTE, P.E.

General Manager

Gates

Industrial-Commercial

DOUBLE SWING GATES

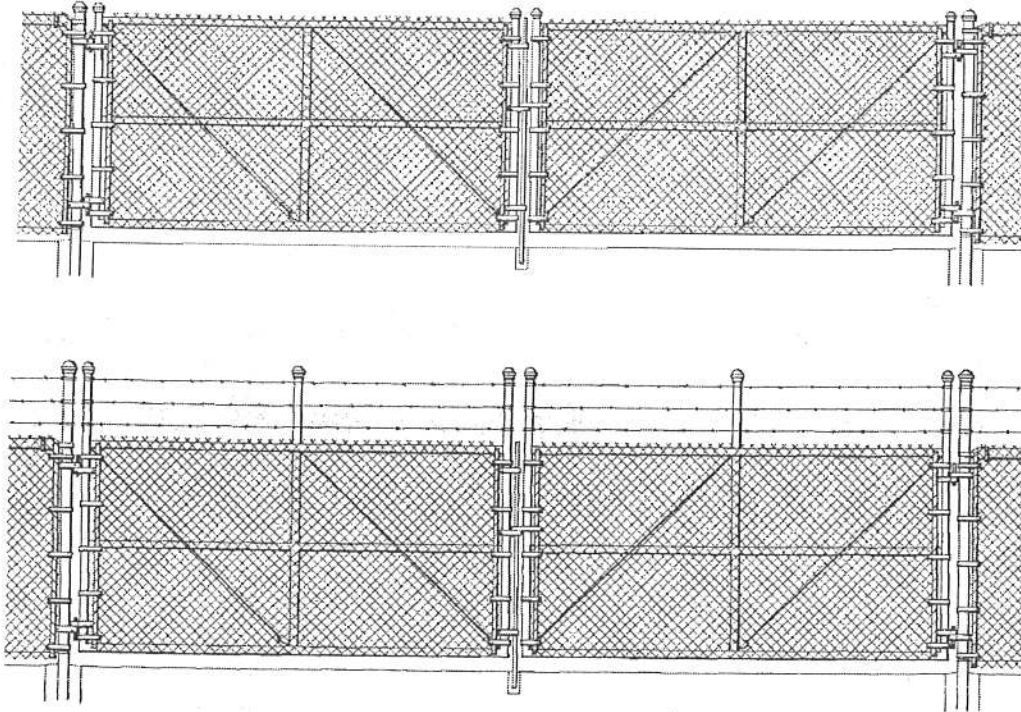

INDUSTRIAL DOUBLE GATES


NOTE: With or without Barb Wire. Without hardware. Weight is approximate.

OPENING SIZE	TYPE OF FRAME	5' HIGH (Overall Height)			6' HIGH (Overall Height)			7' HIGH (Overall Height)			8' HIGH (Overall Height)		
		PART NO.	WEIGHT	PRICE	PART NO.	WEIGHT	PRICE	PART NO.	WEIGHT	PRICE	PART NO.	WEIGHT	PRICE
14'0" to 17'11"	1-5/8" Tube	025013	167.0 lb.		025057	185.0 lb.		025101	209.0 lb.		025145	227.0 lb.	
	1-5/8" CQ/STR	025014	195.0 lb.		025058	217.0 lb.		025102	240.0 lb.		025146	261.0 lb.	
	1-5/8" DQ/FW	025015	224.0 lb.		025059	249.0 lb.		025103	274.0 lb.		025147	299.0 lb.	
	1-7/8" DQ/FW	025016	234.0 lb.		025060	257.0 lb.		025104	281.0 lb.		025148	304.0 lb.	
18'0" to 21'11"	1-5/8" CQ/STR	025021	247.0 lb.		025065	272.0 lb.		025109	298.0 lb.		025153	324.0 lb.	
	1-5/8" DQ/FW	025022	280.0 lb.		025066	308.0 lb.		025110	336.0 lb.		025154	364.0 lb.	
	1-7/8" DQ/FW	025024	318.0 lb.		025068	349.0 lb.		025112	379.0 lb.		025156	410.0 lb.	
22'0" to 26'11"	1-5/8" CQ/STR	025029	279.0 lb.		025073	307.0 lb.		025117	336.0 lb.		025161	365.0 lb.	
	1-5/8" DQ/FW	025030	316.0 lb.		025074	347.0 lb.		025118	378.0 lb.		025162	409.0 lb.	
	1-7/8" DQ/FW	025032	360.0 lb.		025076	393.0 lb.		025120	426.0 lb.		025164	461.0 lb.	


Item 33




item 35

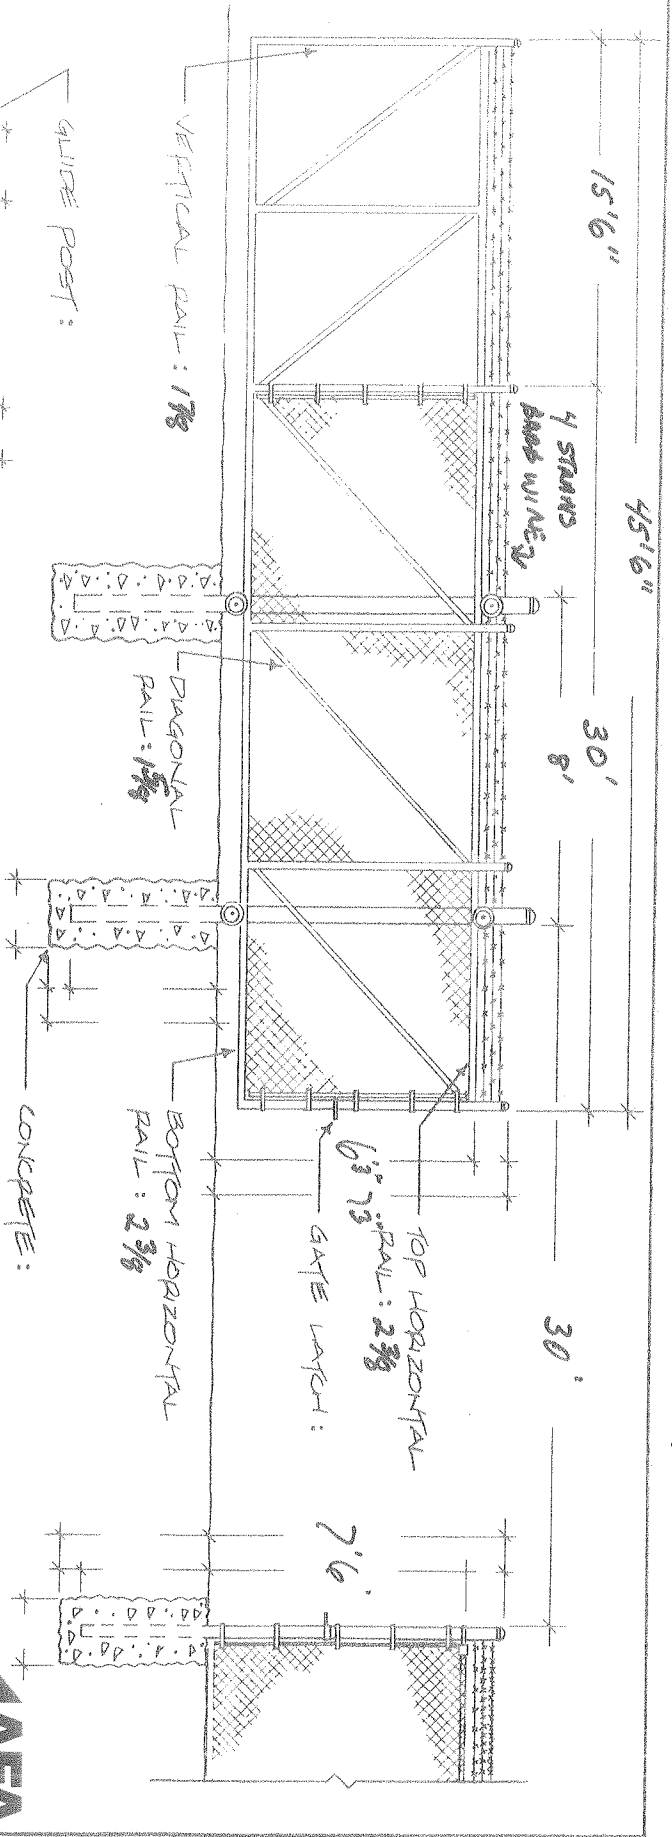

FRONT VIEW

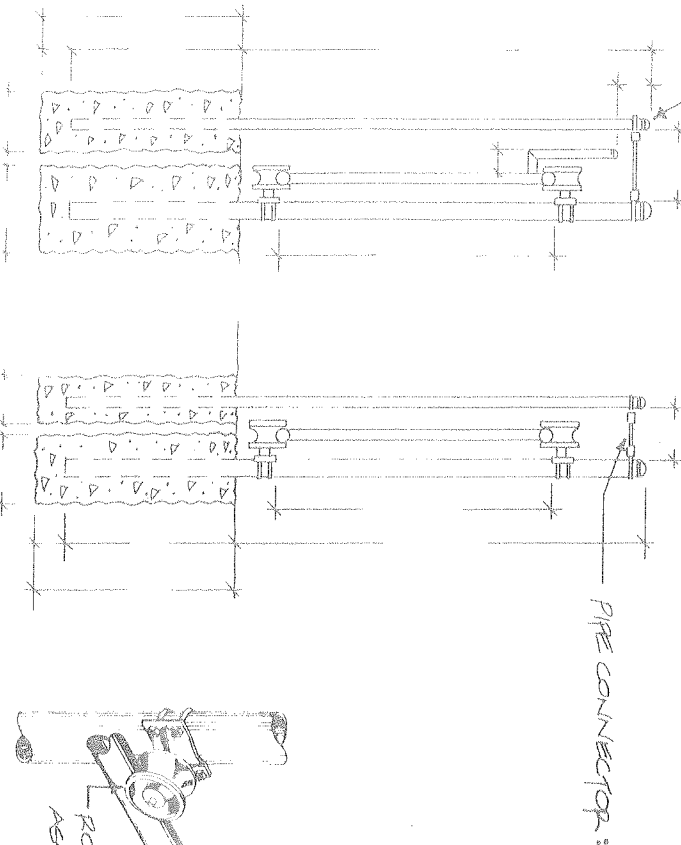


SIDE VIEW

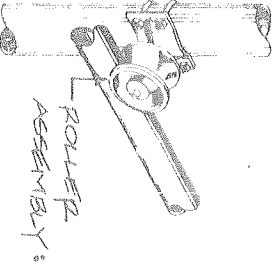

DETAIL

FULL CANTILEVER SLIDE GATE DETAIL
STYLE:

NTS

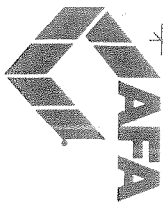

Copyright © AFA 1993

PROJECT	KORANDD GPA GWA Bldg - Fence
OWNER/GEN. CON.	Coretech International
SUBMITTED BY	AISI
DRAWING NO.	CL-36
DATE	